



DEPARTMENT OF REGULATORY AND ECONOMIC RESOURCES (RER)
BOARD AND CODE ADMINISTRATION DIVISION

NOTICE OF ACCEPTANCE (NOA)

MIAMI-DADE COUNTY
PRODUCT CONTROL SECTION

11805 SW 26 Street, Room 208
Miami, Florida 33175-2474
T (786) 315-2590 F (786) 315-2599

www.miamidade.gov/economy

Gordon Sales, Inc.
5023 Hazel Jones Road
Bossier City, LA 71111

SCOPE:

This NOA is being issued under the applicable rules and regulations governing the use of construction materials. The documentation submitted has been reviewed and accepted by Miami-Dade County RER-Product Control Section to be used in Miami Dade County and other areas where allowed by the Authority Having Jurisdiction (AHJ).

This NOA shall not be valid after the expiration date stated below. The Miami-Dade County Product Control Section (In Miami Dade County) and/or the AHJ (in areas other than Miami Dade County) reserve the right to have this product or material tested for quality assurance purposes. If this product or material fails to perform in the accepted manner, the manufacturer will incur the expense of such testing and the AHJ may immediately revoke, modify, or suspend the use of such product or material within their jurisdiction. RER reserves the right to revoke this acceptance, if it is determined by Miami-Dade County Product Control Section that this product or material fails to meet the requirements of the applicable building code.

This product is approved as described herein, and has been designed to comply with the Florida Building Code, including the High Velocity Hurricane Zone.

DESCRIPTION: Soffit-Shield Aluminum and Steel Siding and Soffit System

APPROVAL DOCUMENT: Drawing No. **P0702745R**, titled "Soffit Shield System", sheets 1 through 3 of 3, dated 09/11/2007, with last revision R dated 07/10/2008, prepared by Gordon Sales, Inc., signed and sealed by Robert J. McCloy, P.E., bearing the Miami-Dade County Product Control renewal stamp with the Notice of Acceptance number and expiration date by the Miami-Dade County Product Control Section.

MISSILE IMPACT RATING: Large and Small Missile Impact Resistant

LABELING: Each panel shall be permanently marked with a number or marking and the packaging shall include the manufacturer's name, city and state, model number or name, Miami-Dade County NOA number and test standards per FBC 1715.9.2 and 1715.9.3.

RENEWAL of this NOA shall be considered after a renewal application has been filed and there has been no change in the applicable building code negatively affecting the performance of this product.

TERMINATION of this NOA will occur after the expiration date or if there has been a revision or change in the materials, use, and/or manufacture of the product or process. Misuse of this NOA as an endorsement of any product, for sales, advertising or any other purposes shall automatically terminate this NOA. Failure to comply with any section of this NOA shall be cause for termination and removal of NOA.

ADVERTISEMENT: The NOA number preceded by the words Miami-Dade County, Florida, and followed by the expiration date may be displayed in advertising literature. If any portion of the NOA is displayed, then it shall be done in its entirety.

INSPECTION: A copy of this entire NOA shall be provided to the user by the manufacturer or its distributors and shall be available for inspection at the job site at the request of the Building Official.

This NOA renews NOA # 08-0505.07 and consists of this page 1 and evidence page E-1, as well as approval document mentioned above.

The submitted documentation was reviewed by Carlos M. Utrera, P.E.



[Signature]
01/08/2014

NOA No. 13-0813.24
Expiration Date: August 14, 2018
Approval Date: January 16, 2014
Page 1

NOTICE OF ACCEPTANCE: EVIDENCE SUBMITTED

A. DRAWINGS “Submitted under NOA # 08-0505.07”

1. Drawing No. **P0702745R**, titled “Soffit Shield System”, sheets 1 through 3 of 3, dated 09/11/2007, with last revision R dated 07/10/2008, prepared by Gordon Sales, Inc., signed and sealed by Robert J. McCloy, P.E.

B. TESTS “Submitted under NOA # 08-0505.07”

1. Test reports on 1) Air Infiltration Test, per FBC, TAS 202-94
2) Uniform Static Air Pressure Test, Loading per FBC TAS 202-94
3) Water Resistance Test, per FBC, TAS 202-94
4) Large Missile Impact Test per FBC, TAS 201-94
5) Cyclic Wind Pressure Loading per FBC, TAS 203-94
along with marked-up drawings and installation diagram of Soffit Shield Panels, prepared by Construction Research Laboratory, Inc., Test Report No. **7228**, dated 04/21/2008, signed and sealed by Nariman S. Balsara, P.E.

C. CALCULATIONS “Submitted under NOA # 08-0505.07”

1. Structural calculations of the Aluminum Soffit Shield System, prepared by Design Engineering & Construction, Inc, dated 07/10/2008, signed and sealed by Robert J. McCloy, P.E.

D. QUALITY ASSURANCE

1. Miami-Dade Department of Regulatory and Economic Resources (RER)

E. MATERIAL CERTIFICATIONS “Submitted under NOA # 08-0505.07”

1. Test report on metallurgical test per ASTM A653 of the Steel Backer Panel, prepared by Nucor Sheet Mill Group, dated 02/22/2008, signed by Shane Beasley.
2. Test report prepared by Commonwealth Aluminum Metals, LLC, on chemical composition and mechanical properties per ASTM B209 and B557, dated 03/05/2008 and 03/21/2008 and certified by V. Outerbridge and J. Fulkerson respectively.

F. STATEMENTS

1. Statement letter of code conformance to 2010 FBC issued by Design Engineering & Consulting, Inc., dated 11/21/2013, signed and sealed by Robert J. McCloy, P.E.

“Submitted under NOA # 08-0505.07”
2. Statement letter of no financial interest issued by Design Engineering & Consulting, Inc., dated 06/12/2008, signed and sealed by Robert J. McCloy, P.E.
3. Laboratory compliance statement issued by Construction Research Laboratory, Inc. for Test Report No. **7228**, dated 04/21/2008, signed and sealed by Nariman S. Balsara, P.E.


01/08/2014

Carlos M. Utrera, P.E.
Product Control Examiner
NOA No. 13-0813.24

Expiration Date: August 14, 2018
Approval Date: January 16, 2014

- LEGEND
- COMPONENT IDENTIFIER
 - PANEL IDENTIFIER
 - NOTE REFERENCE
 - REVISION REFERENCE
 - × ATTACHMENT TO STRUCTURE LOCATION
 - SECTION LETTER IDENTIFIER
 - DIRECTION OF VIEW
 - SHEET LOCATION OF DETAIL
 - ELEVATION LETTER IDENTIFIER
 - DIRECTION OF VIEW
 - SHEET LOCATION OF DETAIL

LARGE MISSILE IMPACT (TAS 201)
THE SPECIMEN WAS IMPACTED WITH A 9lb. SOUTHERN PINE 2 X 4 TRAVELING AT 50 fps AT NINE LOCATIONS SHOWN ON THE IMPACT LOCATION SKETCH

CYCLED PRESSURE (TAS 203)
THE SPECIMEN WAS SUBJECTED TO CYCLED STATIC PRESSURE STRUCTURAL LOADS WITH EACH CYCLE BEING ONE TO THREE SECONDS IN DURATION, AS FOLLOWS.

PANELS

POSITIVE LOADS (+125 psf DL)

600 @ 0 to 0.5p = 0 to +62.5 psf
70 @ 0 to 0.6p = 0 to +75.0 psf
1 @ 0 to 1.3p = 0 to +162.5 psf

NEGATIVE LOADS (-125 psf DL)



600 @ 0 to 0.5p = 0 to -62.5 psf
70 @ 0 to 0.6p = 0 to -75.0 psf
1 @ 0 to 1.3p = 0 to -162.5 psf

SCALING INSTRUCTIONS

This document has been plotted on 11x17 paper for ease of handling. To correctly scale this drawing, obtain the desired dimension (using the appropriate scale specified in the "DRAWING SCALE" box of the title block). Then multiply your scale reading by the modifier specified in the "PLOTTER SCALE" box of the title block. A plotted scale of 2:3 results in a modifier of 1.5 (3÷2) and a scale of 1:2 results in a modifier of 2 (2÷1). Full size plots are available upon request, please make such requests through your sales representative.

GENERAL NOTES:



- ABBREVIATIONS:
VIF = VERIFY IN FIELD
UNO = UNLESS NOTED OTHERWISE
TYP = TYPICAL
REF = REFERENCE
OD = OUTSIDE DIMENSION/DIAMETER
ID = INSIDE DIMENSION/DIAMETER
- FRACTIONAL DIMENSIONS REPRESENTED TO 1/8"
DECIMAL DIMENSIONS REPRESENTED TO .001"
- ANY HANGER LOCATIONS ARE SUGGESTED, REFER TO TO ASTM C635-00 & C636-96 AND APPROPRIATE SEISMIC CODES FOR HANGER REQUIREMENTS
- NON-SYMMETRICAL COMPONENTS MAY BE SUPPLIED WITH AN ADDITIONAL COMPONENT MARK IDENTIFIER NEAR THE END OF THE PART. THIS ADDITIONAL MARK INDICATES THE ADJACENT COMPONENT THAT SHOULD BE CONNECTED TO THE IDENTIFIED END OF SAID COMPONENT AS AN AID FOR PART ORIENTATION.

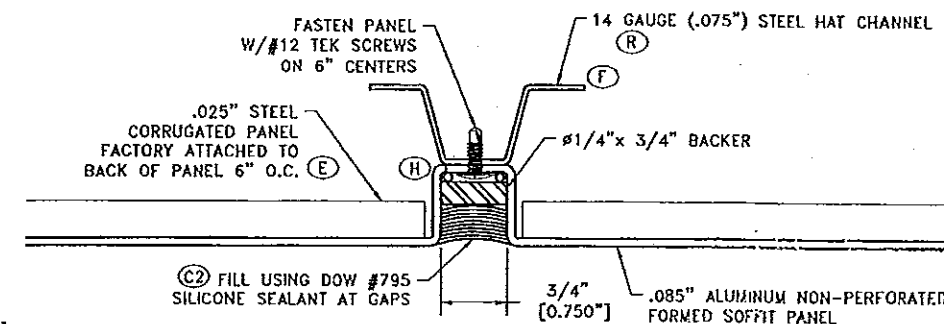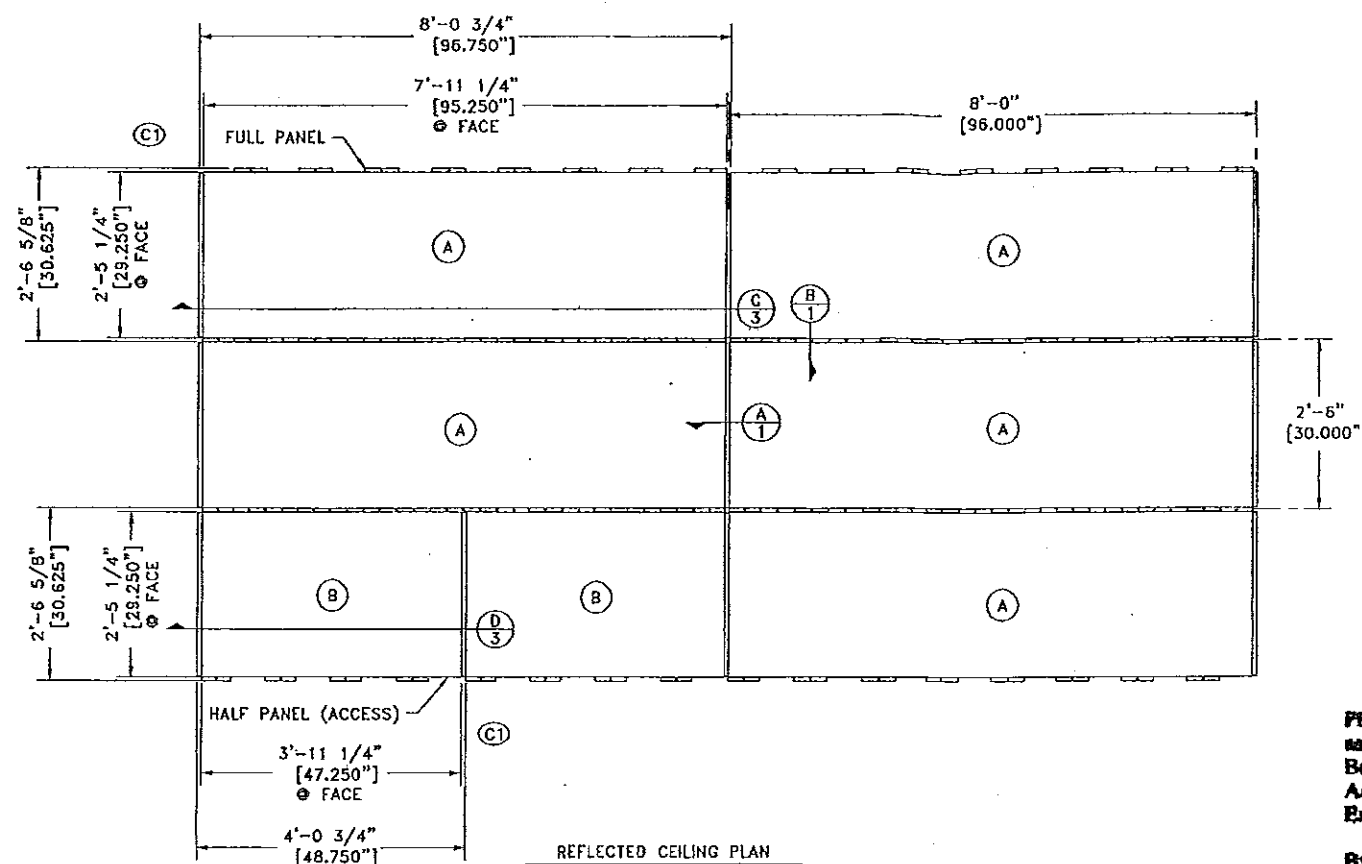

SCALE: FULL
B TYPICAL INTERLOCK REVEAL

PRODUCT RENEWED
as complying with the Florida Building Code
Acceptance No. 13-0813.24
Expiration Date: 08/14/2018
By: [Signature]
Miami Dade Product Control

Approved as complying with the Florida Building Code
Date: 08/14/2008
NOAH 104-0505.07
Miami Dade Product Control
Division: [Signature]
By: [Signature]

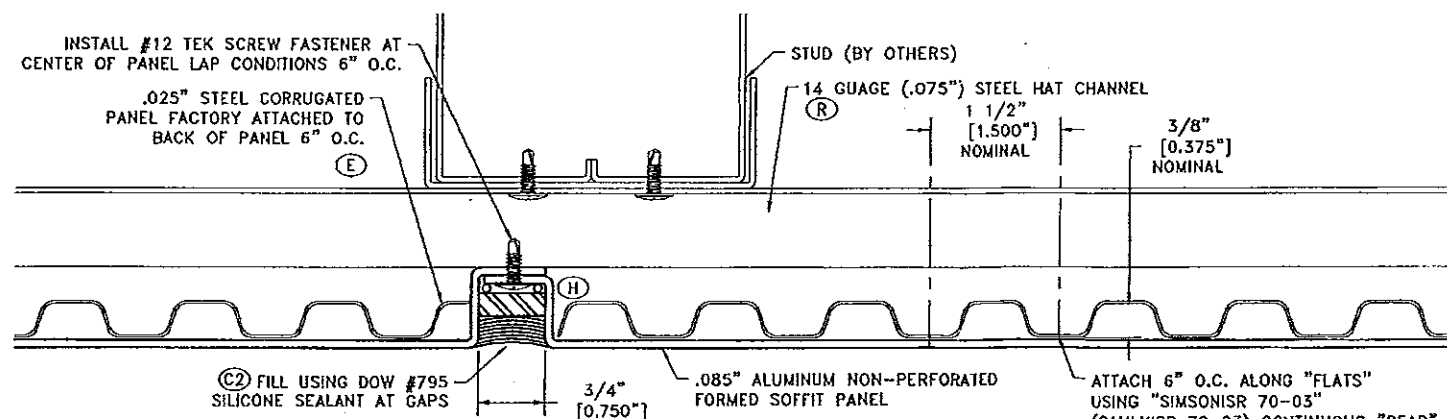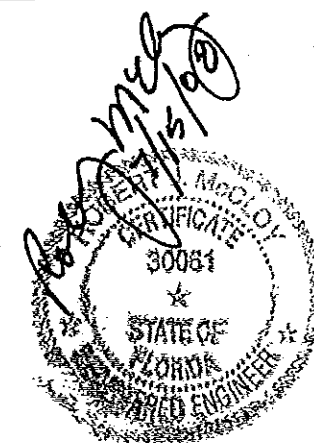


SCALE: FULL
A TYPICAL LAP REVEAL

THE INFORMATION CONTAINED IN THIS, AND ANY ACCOMPANYING DOCUMENTS, REPRESENTS DESIGN INTENT FOR THE MANUFACTURING OF COMPONENTS BY OUR FACILITIES AND MAKE NO REPRESENTATION THAT COMPONENTS OR ASSEMBLY METHODS APPLY WITH ALL APPLICABLE LOCAL CODES OR ORDINANCES. PURCHASER TO VERIFY COMPLIANCE WITH ALL SUCH CODES AND ORDINANCES PRIOR TO APPROVING FOR CONSTRUCTION.

THE DESIGN AND CONCEPTS REPRESENTED BY THIS PRINT AND ACCOMPANYING DOCUMENTS ARE THE SOLE PROPERTY OF GORDON, INC. AND MAY NOT BE USED, COPIED, OR REPRODUCED WITHOUT PRIOR WRITTEN CONSENT OF SAID OFFICE.

GORDON INTERIOR SPECIALTIES DIVISION		5923 HAZEL JONES ROAD, BOSSIER CITY, LA 71111 800.747.8954 800.877.8744 FAX SALES@GORDONCEILING.COM GORDONCEILING.COM		SALES CODE	JOB NAME	CUSTOMER	GORDON	SHEET TITLE	SOFFIT SHIELD SYSTEM		SHEET	1 of 3	SALES ORDER	46114	PATH & DRAWING NUMBER	H:\DWG\LAYOUTS\SYSTEMS\GORDON SOFFIT & FASCIA SYSTEM - 45652	REVISION	Q	P0702745R
--	--	---	--	------------	----------	----------	--------	-------------	----------------------	--	-------	--------	-------------	-------	-----------------------	--	----------	---	-----------


R	7/10/08	TJS			CHANGED .056 STEEL HAT CHANNEL TO 14 GAUGE (.075") STEEL HAT CHANNEL								
Q	7/1/08	TJS			ADD AND DELETE NOTES PER CUSTOMER MARKUPS								
P	3/17/08	TJS			ADDED TO THE NEW DETAIL N								
N	2/29/08	TJS			REVISED DETAIL A AND REMOVED DETAIL G								
M	2/29/08	TJS			CHANGE DETAIL M AND ADDED DETAIL N								
L	2/25/08	TJS			CHANGE DETAIL N TO MATCH DETAIL H								
K	2/19/08	TJS			CHANGED BACKER ROD TO BACKER BLOCK ON DETAIL A,B AND J, AND ADDED SEALANT WHERE NEEDED								
J	2/12/08	TJS			ADDED SEALANT TO THE HAT CHANNEL AND THE STUDS AND THE STUDS 5'-0" ON CENTER INSTEAD OF 4'-0" ON CENTER								
H	01/30/08	TJS			ADDED STUDS TO BACK OF PROFILE/DOUBLED THE MIDDLE STUDS								
G	01/03/08	TJS			1 AREA REQUIRED WAS 2 AREAS/ CHANGED SALES ORDER # FROM 41814 TO 45652								
F	12/11/07	LJL			UPDATED FRAMING PER MOCKUP AS-BUILT								
E	10/27/07	JEL			24 GA STEEL WAS .063" ALUMINUM								
D	10/19/07	JEL			2 AREAS REQUIRED WAS 3 AREAS								
C4	10/16/07	LJL			3 AREAS REQUIRED WAS 1 AREA								
C3	10/16/07	LJL			CHANGED DIMENSIONS TO BEAMS FROM OD TO ID								
C2	10/15/07	LJL			REMOVED "IF DESIRED" FROM CAULKING NOTES								
C1	10/15/07	LJL			MOVED DETAILED PANELS INTO INSTALLED LOCATIONS								
B	10/08/07	JEL			REVISED PER MARK-UPS								
A	10/04/07	JEL			ADDED SHEET 2 - FRAMING PLAN								
REV	REV DATE	DWN	CKD	CKD DATE	REVISION DESCRIPTION								
COMP DATE	9/11/07	DRAWN BY	LJL	APPROV BY	REL DATE	DRAWING SCALE	3/4" = 1'-0"	PLOTTED SCALE	1:2	SOFTWARE USED	AutoCAD	REVISION	Q
SYSTEM		SHEET		SALES ORDER		PATH & DRAWING NUMBER H:\DWG\LAYOUTS\ PANELS\GORDON SOFFIT & FASCIA SYSTEM - 45652							
		1 of 3		46114		P0702745R							

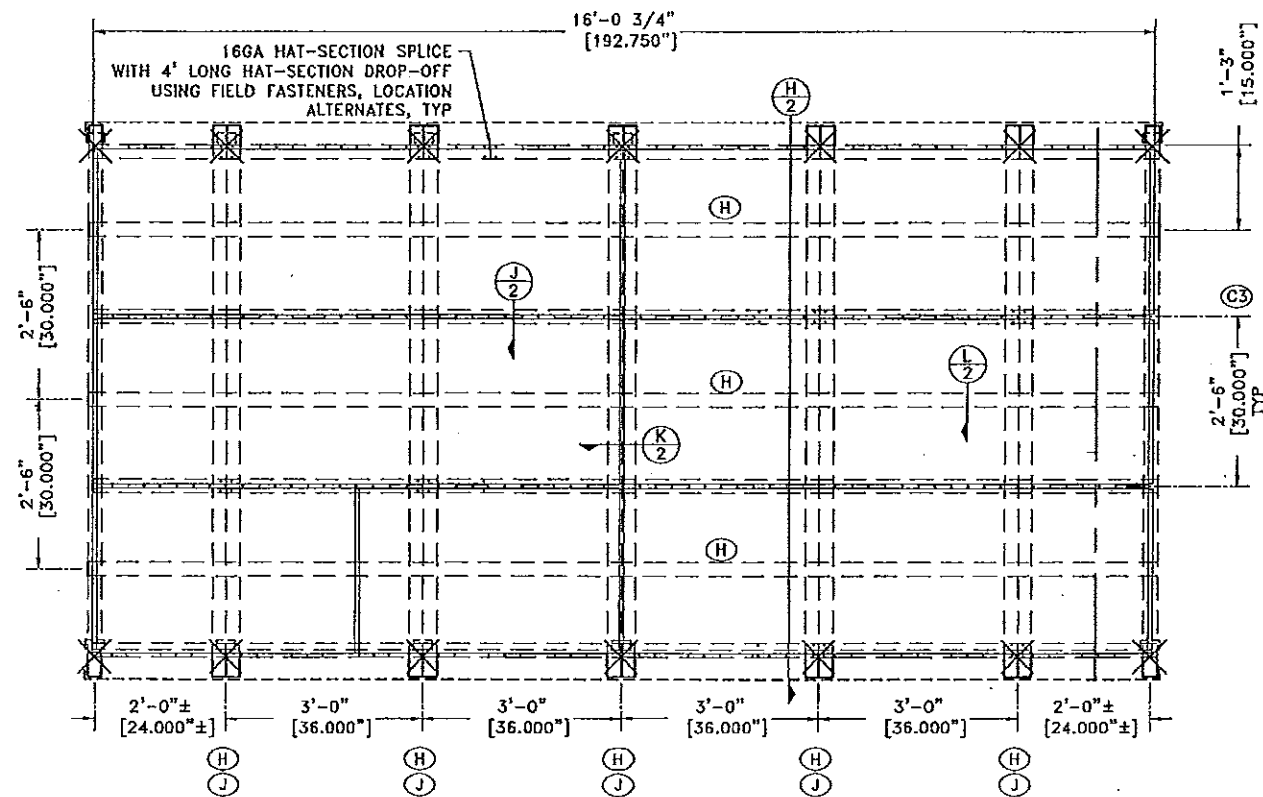


FRAMING PLAN (FACTORY ASSEMBLED)

1 AREAS REQUIRED


(F)

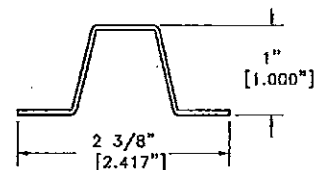


14 GAUGE (.075") STEEL HAT-SECTION
SCALE: FULL

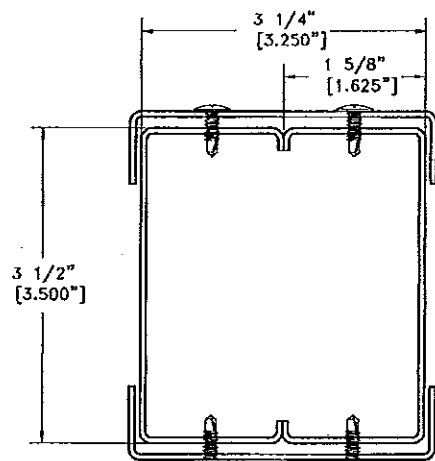

16 GA STEEL STUD (BY OTHERS)
SCALE: FULL

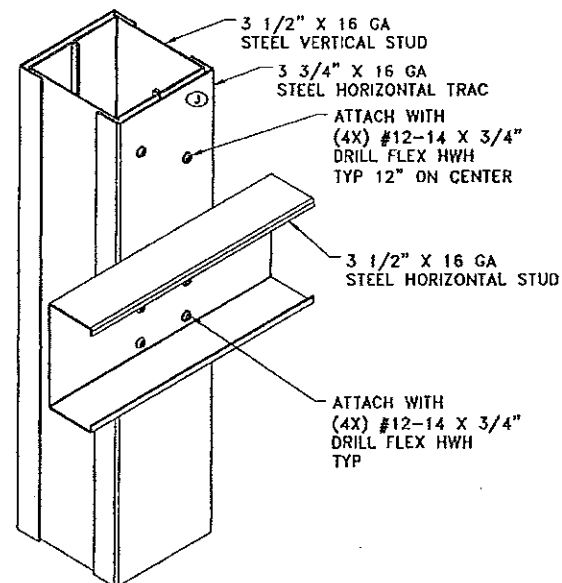

(L) TYPICAL CONNECTION FOR BEHIND STUDS (BY OTHERS)
NOT TO SCALE

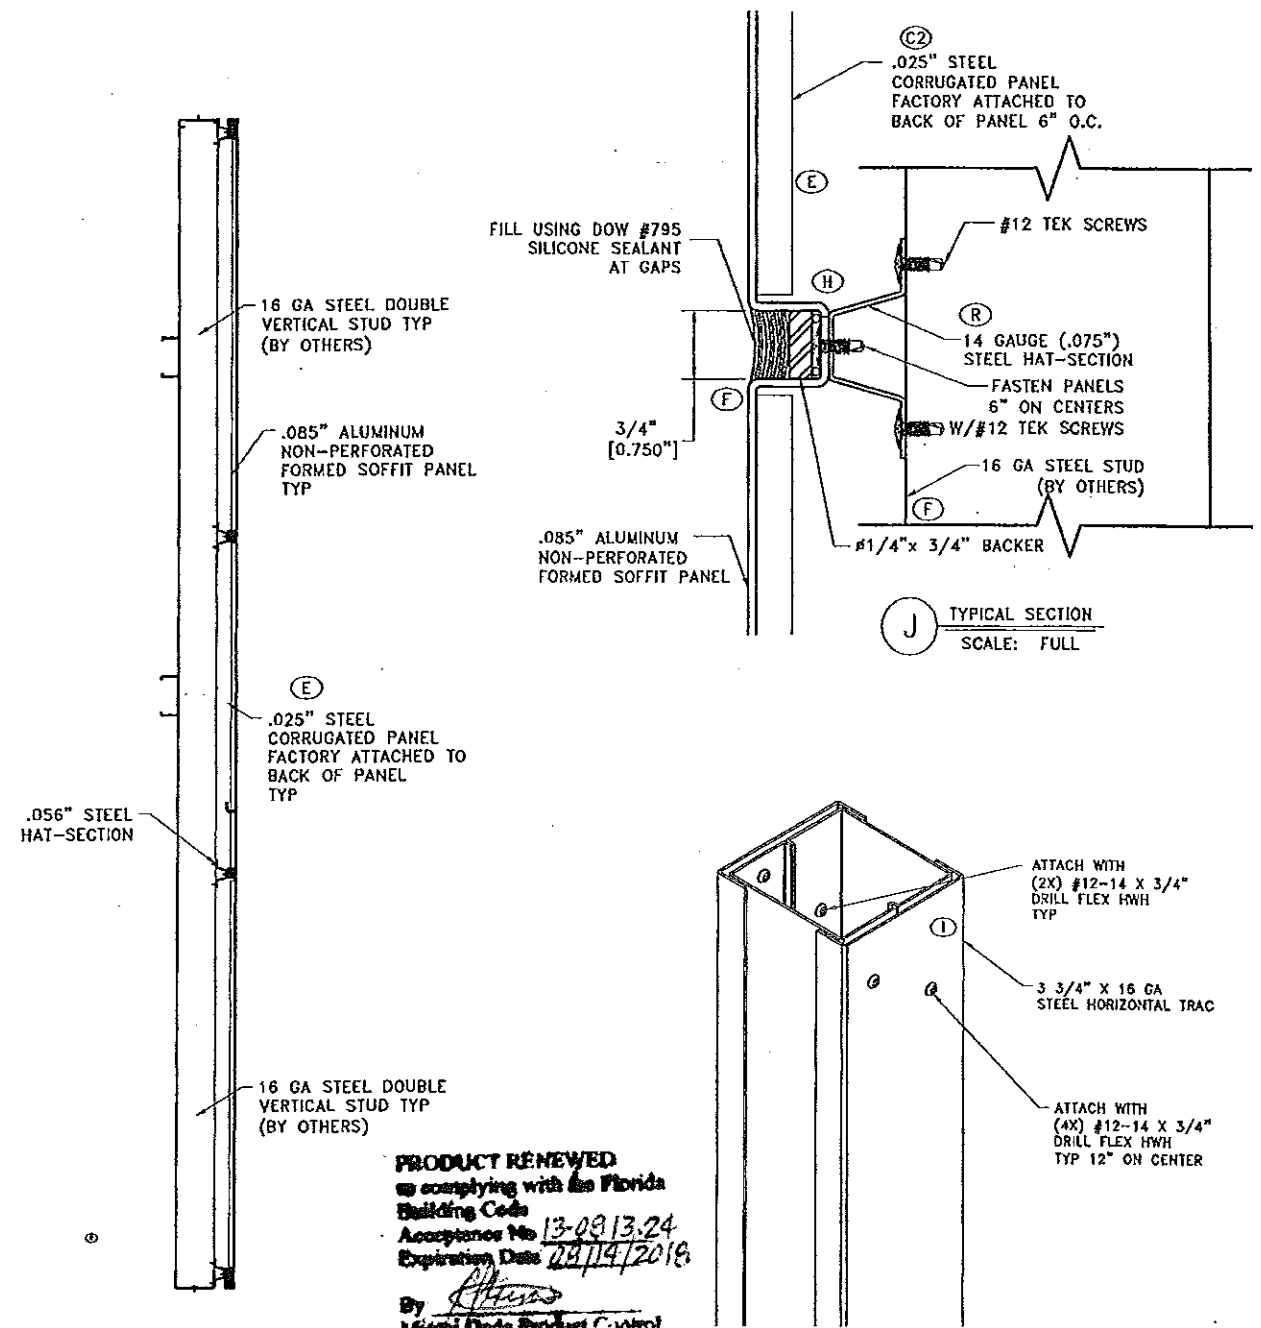


(H) TYPICAL SECTION
SCALE: 1 1/2\"/>

TYPICAL CONNECTION AT TUBE STEEL
NOT TO SCALE

PRODUCT RENEWED
as complying with the Florida
Building Code
Acceptance No. 13-0913.24
Expiration Date 08/14/2018
By *[Signature]*
Miami Data Product Control

Approved as complying with the
Florida Building Code
Date 08/14/2008
MOA# 08-0505.07
Miami Data Product Control
Division *[Signature]*

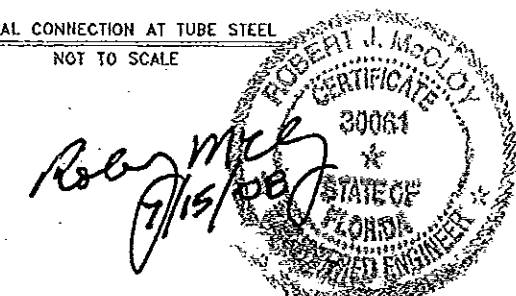


THE DESIGN AND CONCEPTS REPRESENTED BY THIS PRINT AND ACCOMPANYING DOCUMENTS ARE THE SOLE PROPERTY OF GORDON, INC. AND MAY NOT BE USED, COPIED, OR REPRODUCED WITHOUT PRIOR WRITTEN CONSENT OF SAID OFFICE.



GORDON
INTERIOR SPECIALTIES DIVISION

5023 HAZEL JONES ROAD, BOSSIER CITY, LA 71111
800.747.8954
600.877.8745 FAX
SALES@GORDONCEILING.COM
GORDONCEILINGS.COM


SALES CODE	JOB NAME	SEE SHEET 1 FOR NOTE & REVISION DESCRIPTIONS									
SALES D/E #	CUSTOMER	COMP DATE	DRAWN BY	APPROV BY	REL DATE	DRAWING SCALE	PLOTTED SCALE	SOFTWARE USED	REVISION		
	GORDON	9/11/07	LJL			3/4" = 1'-0"	1:2	AutoCAD	Q		
ARCHITECT	SHEET TITLE	SHEET		SALES ORDER		PATH & DRAWING NUMBER					
	GORDON SOFFIT SYSTEM	2 of 3		46114		H:\DWG\LAYOUTS\PAH\GORDON SOFFIT & FASCIA SYSTEM - 45652					
		P0702745R									

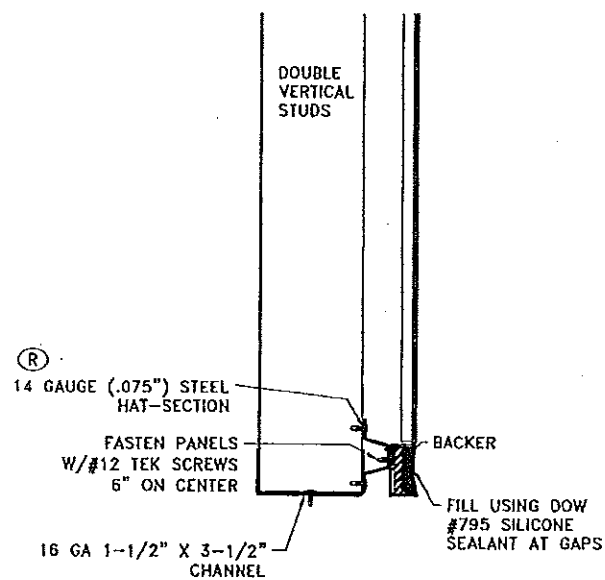


M BASE DETAIL
SCALE: 1:3

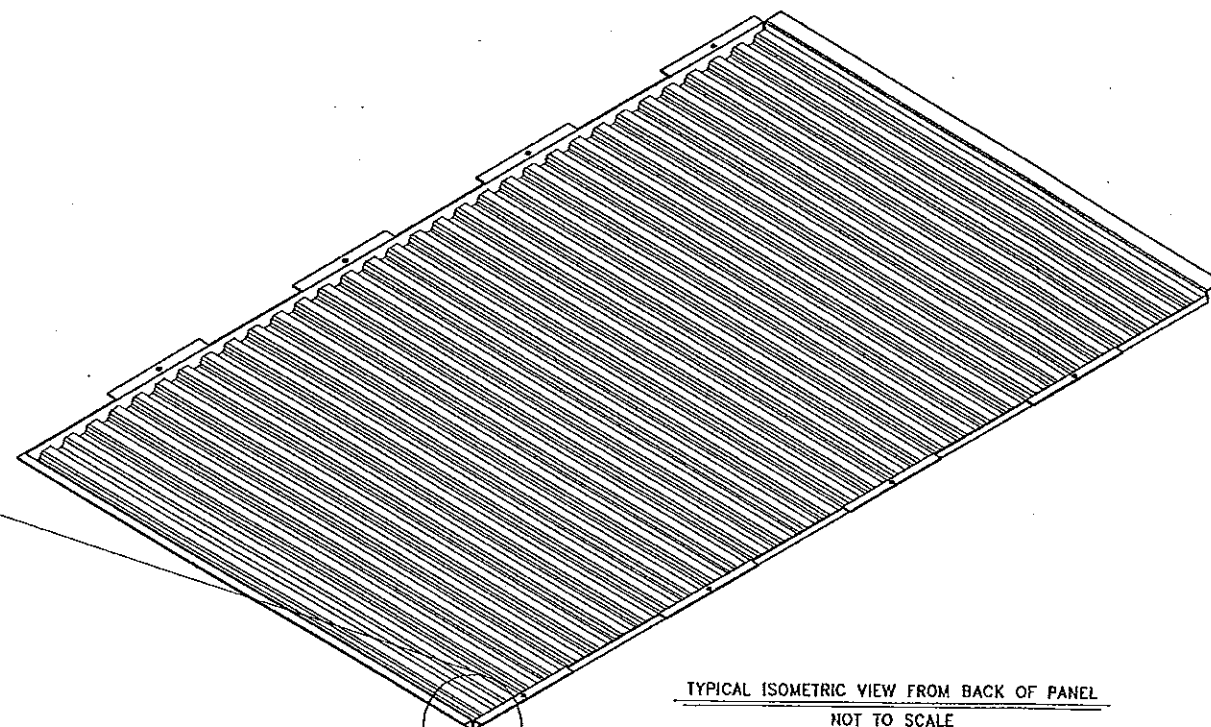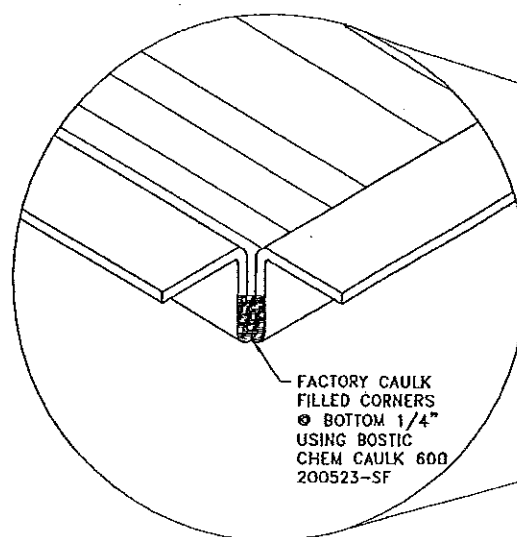

PRODUCT RENEWED
as complying with the Florida
Building Code
Acceptance No. 13-0913.24
Expiration Date 03/14/2018
By [Signature]
Miami Dade Product Control

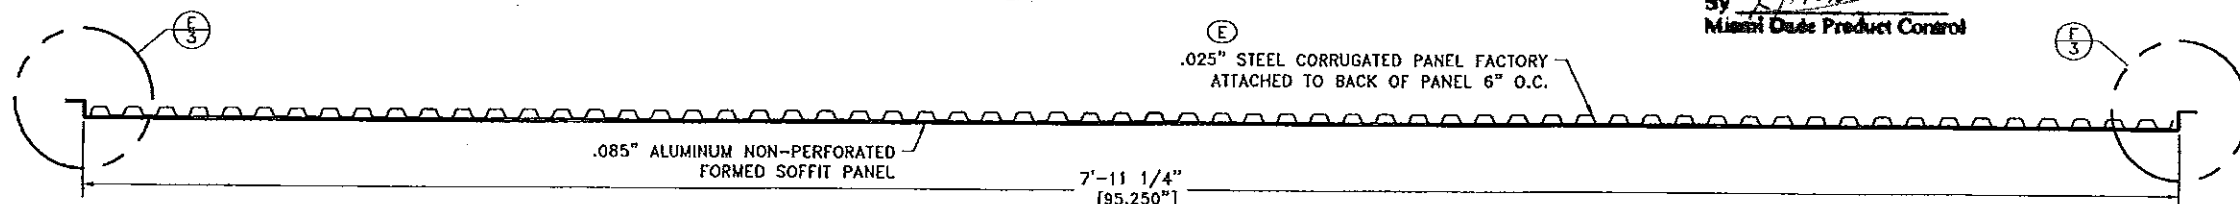

C TYPICAL SECTION THROUGH FULL PANEL A
SCALE: 3" = 1'-0"

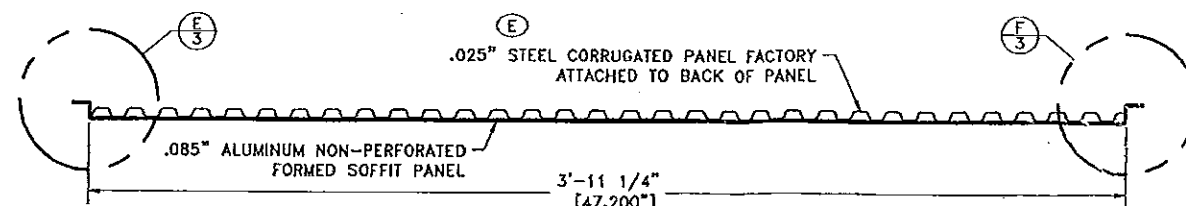


D TYPICAL SECTION THROUGH HALF PANEL B
SCALE: 3" = 1'-0"

Approved as complying with the
Florida Building Code
Date 03/14/2009
NOAH 02-2503.07
Miami Dade Product Control
Division
By [Signature]



E PANEL FLANGE DETAIL
SCALE: FULL

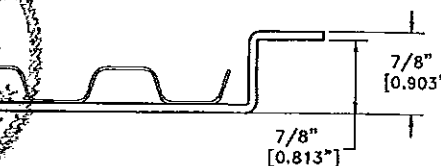

F PANEL FLANGE DETAIL
SCALE: FULL

THE DESIGN AND CONCEPTS REPRESENTED BY THIS PRINT AND ACCOMPANYING DOCUMENTS ARE THE SOLE PROPERTY OF GORDON, INC. AND MAY NOT BE USED, COPIED, OR REPRODUCED WITHOUT PRIOR WRITTEN CONSENT OF SAID OFFICE.

GORDON
INTERIOR SPECIALTIES DIVISION

5020 HAZEL JONES ROAD, BOSSIER CITY, LA 71111
900.747.8154
900.877.8746 FAX
SALES@GORDONCEILING.COM
GORDONCEILING.COM

SALES CODE
SALES DTE #
ARCHITECT
JOB NAME
CUSTOMER
SHEET TITLE

GORDON

SECTIONS & DETAILS

SEE SHEET 1 FOR NOTE & REVISION DESCRIPTIONS

COMP DATE 9/11/07	DRAWN BY L.J.L.	APPROVED BY REL DATE	DRAWING SCALE 3/4" = 1'-0"	PLOTTED SCALE 1:2	SOFTWARE USED AutoCAD	REVISION Q
SHEET 3 OF 3			SALES ORDER 46114	PATH & DRAWING NUMBER H:\DWG\LAYOUTS\PANELS\GORDON SOFFIT & FASCIA SYSTEM - 45632		

P0702745R